


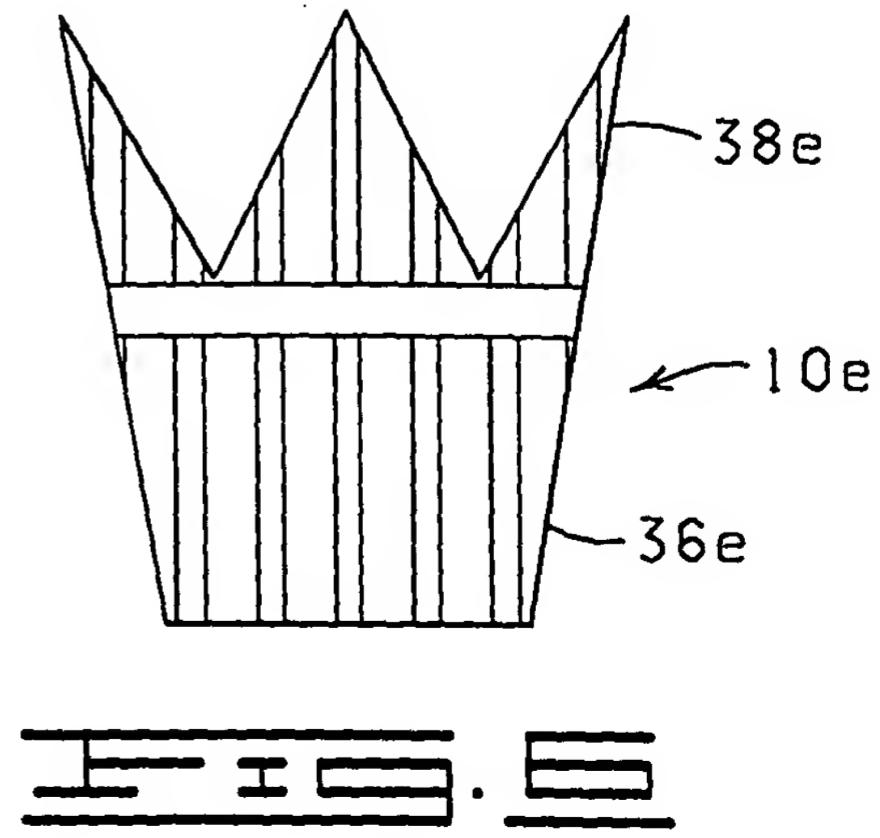
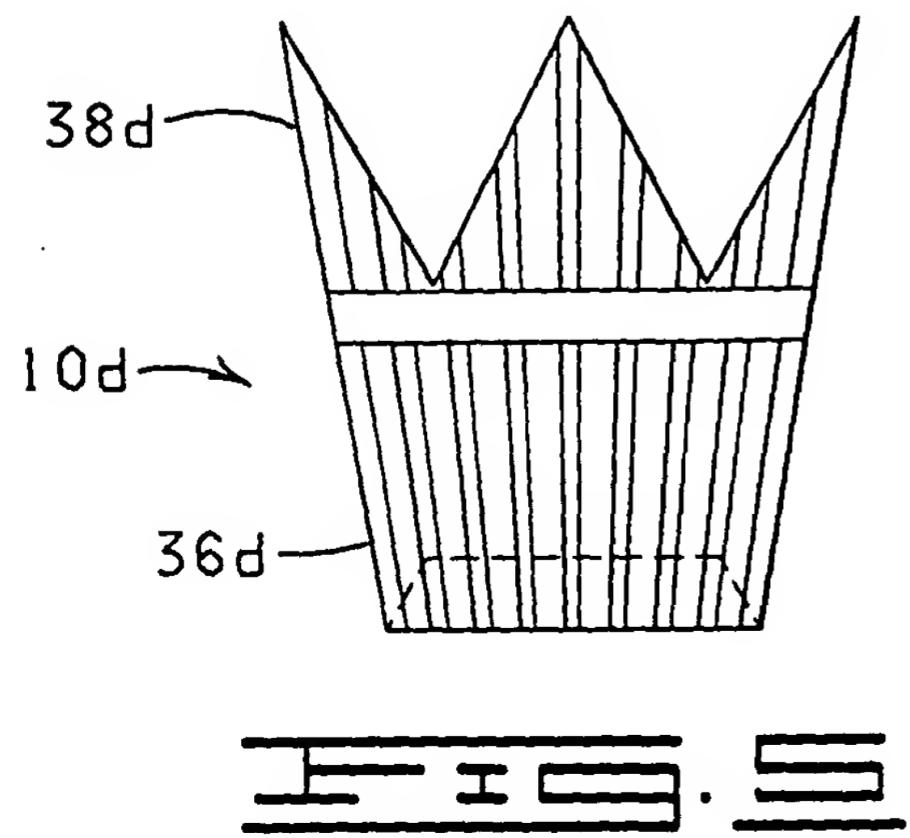
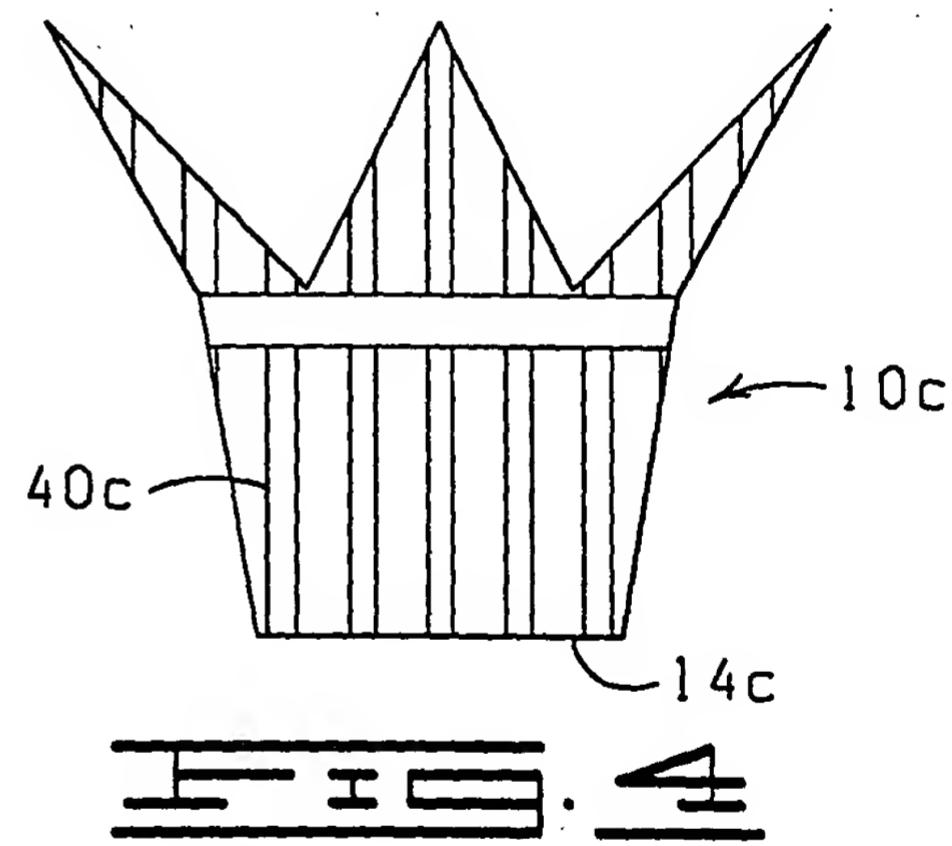
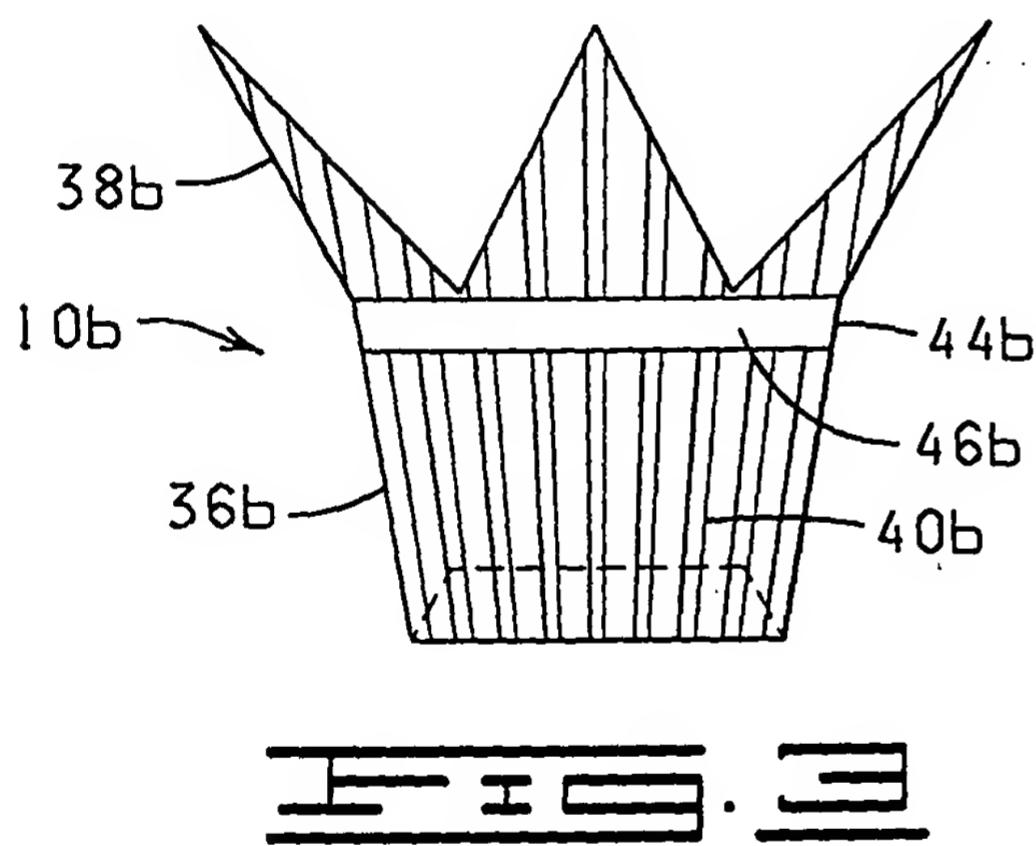
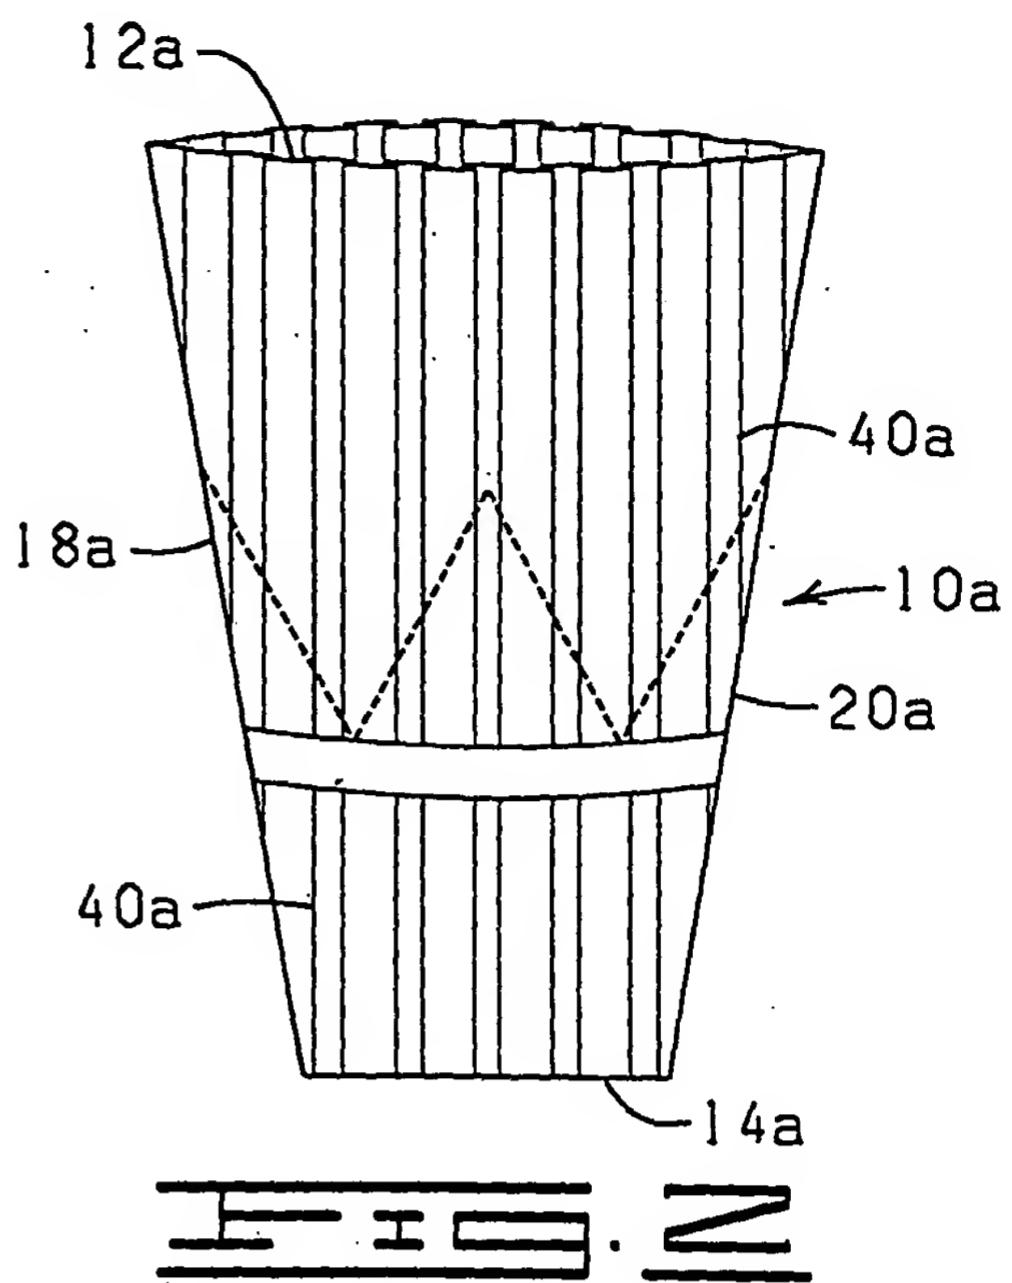
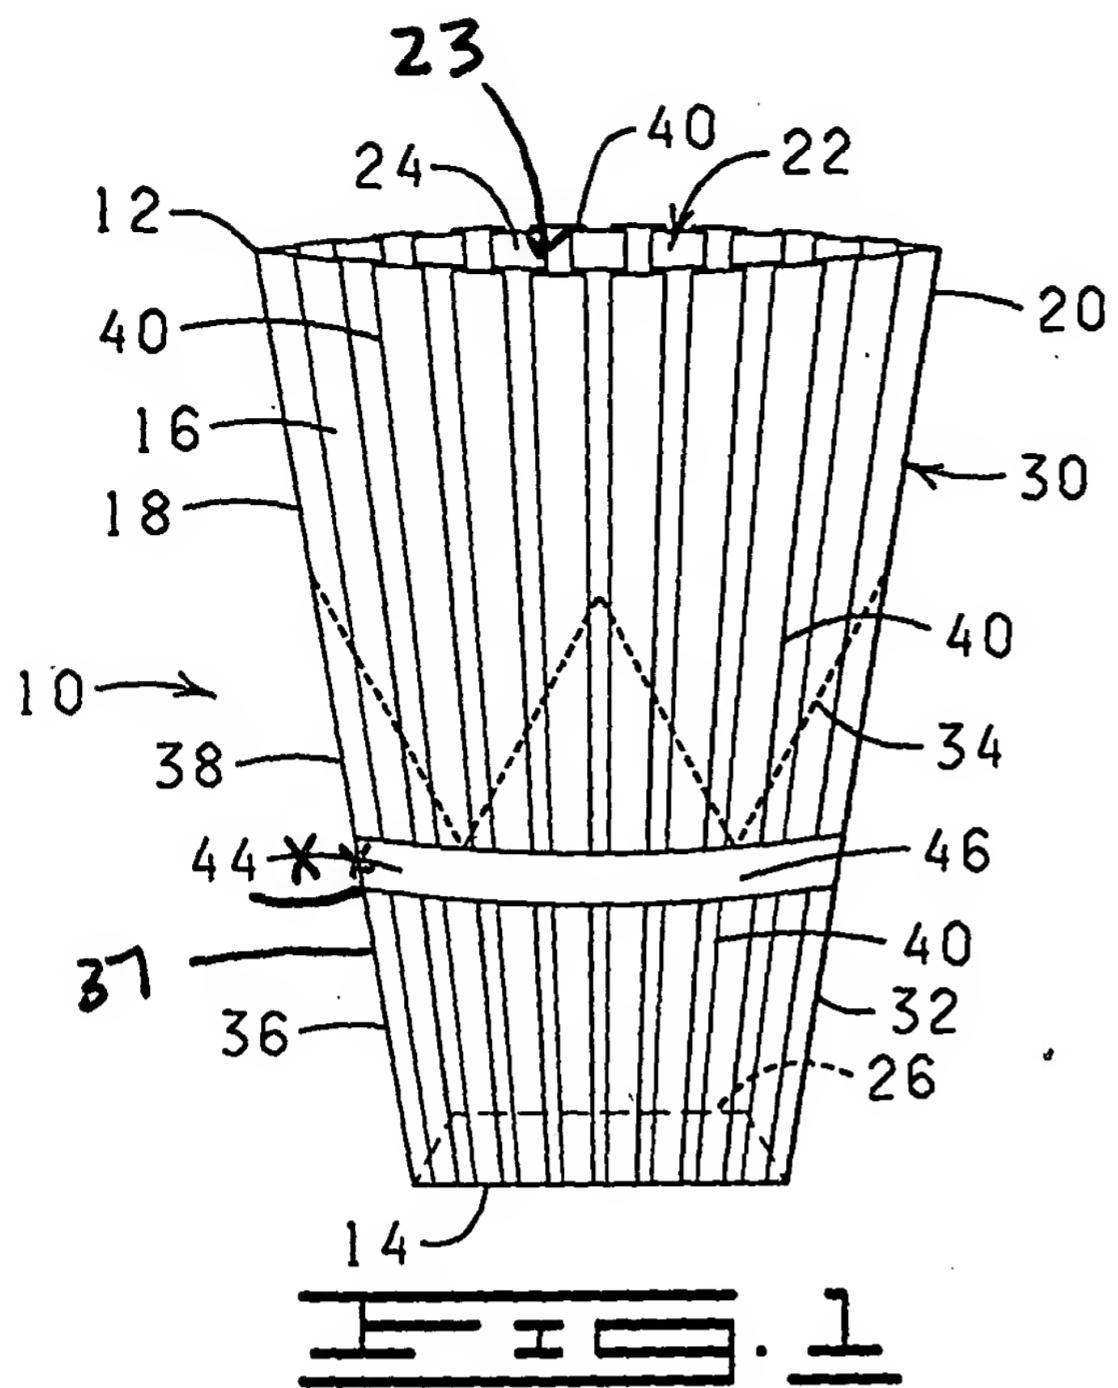
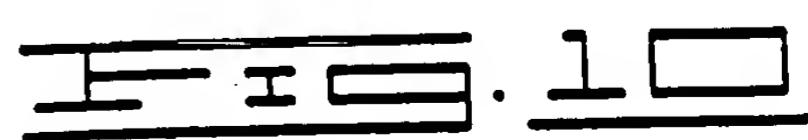
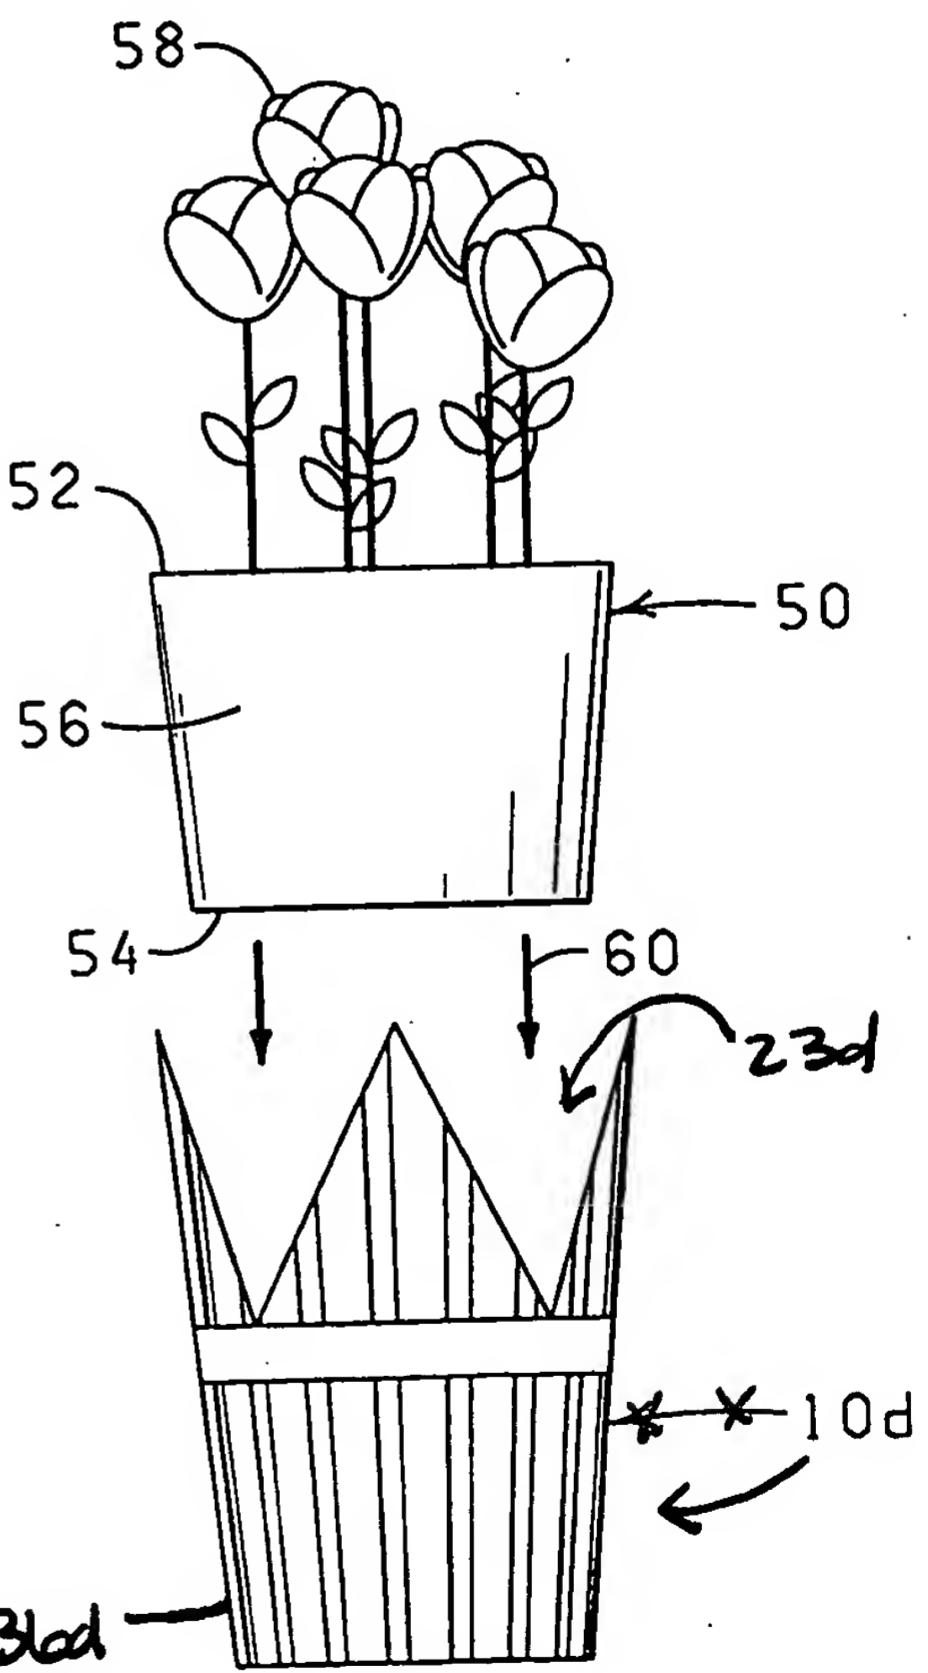
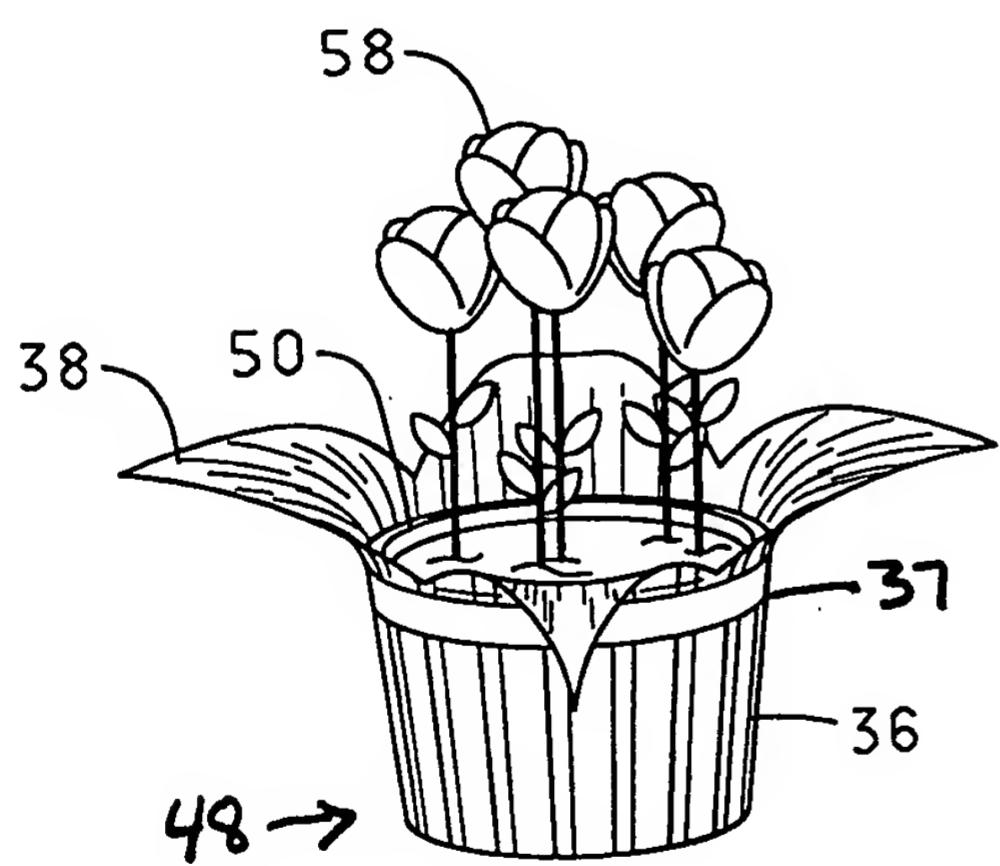



Redline Version of
Drawings: Not for
Publication

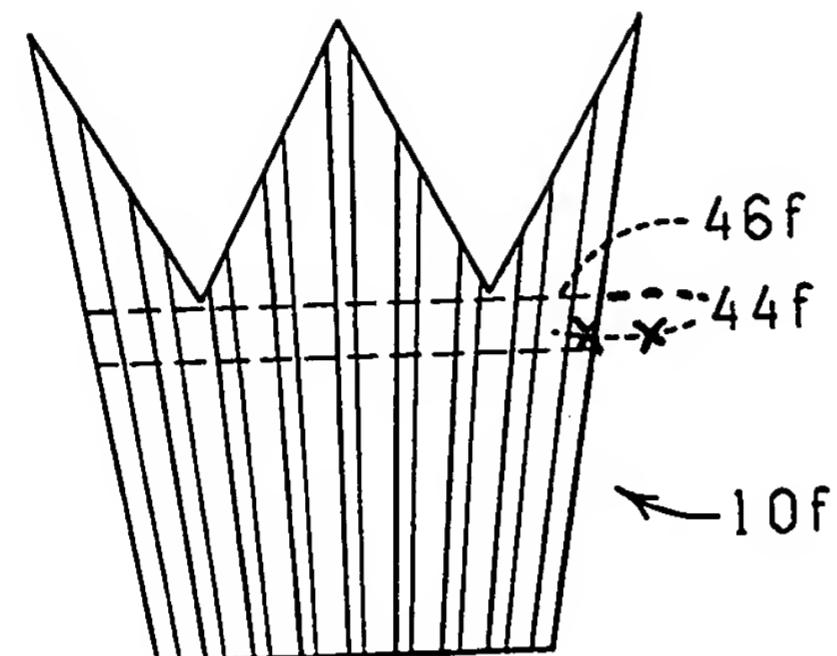

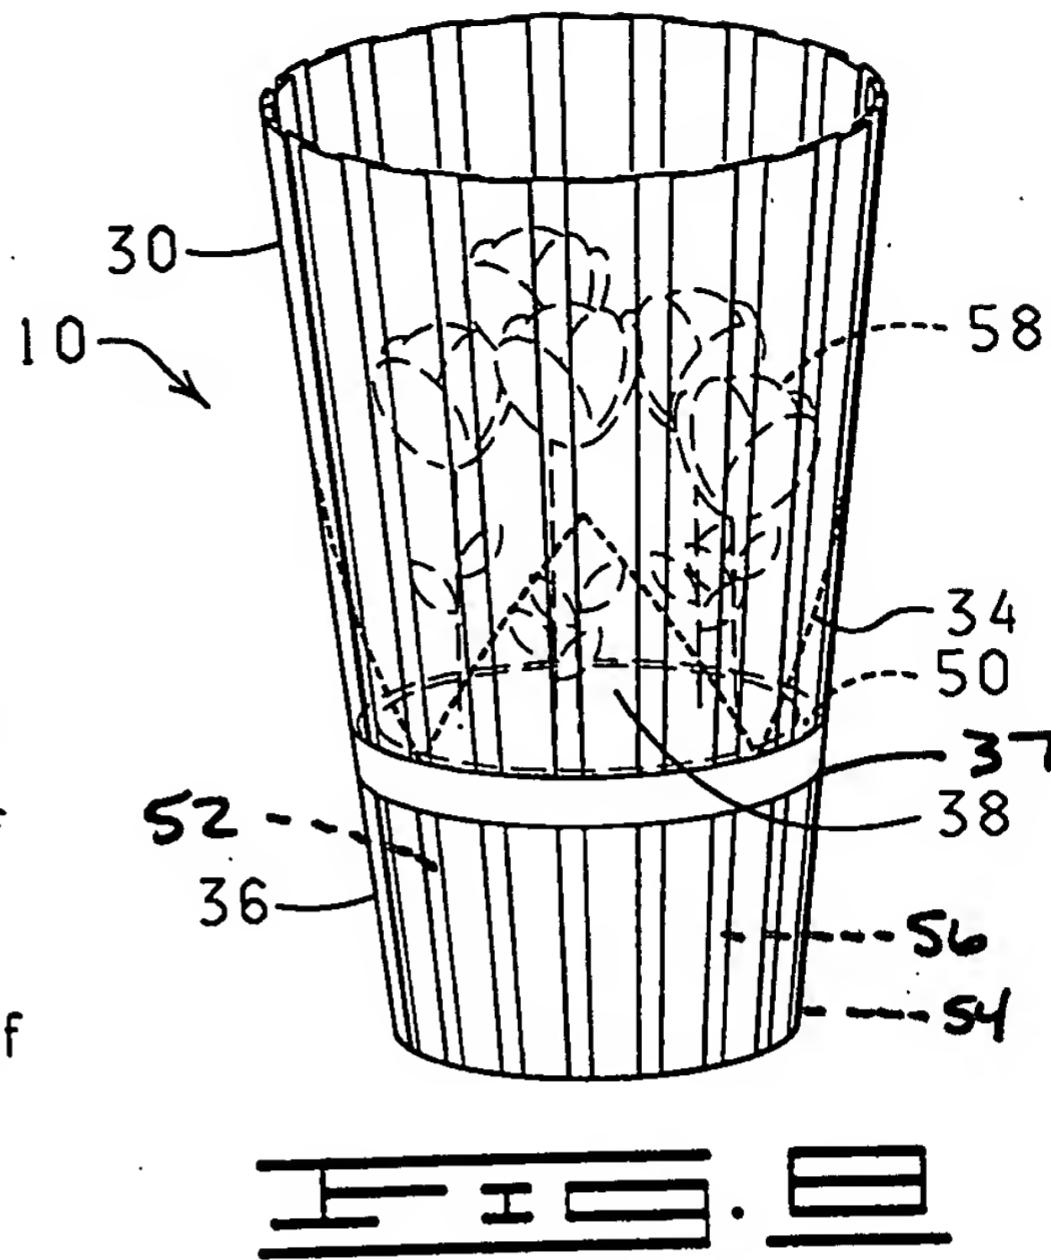


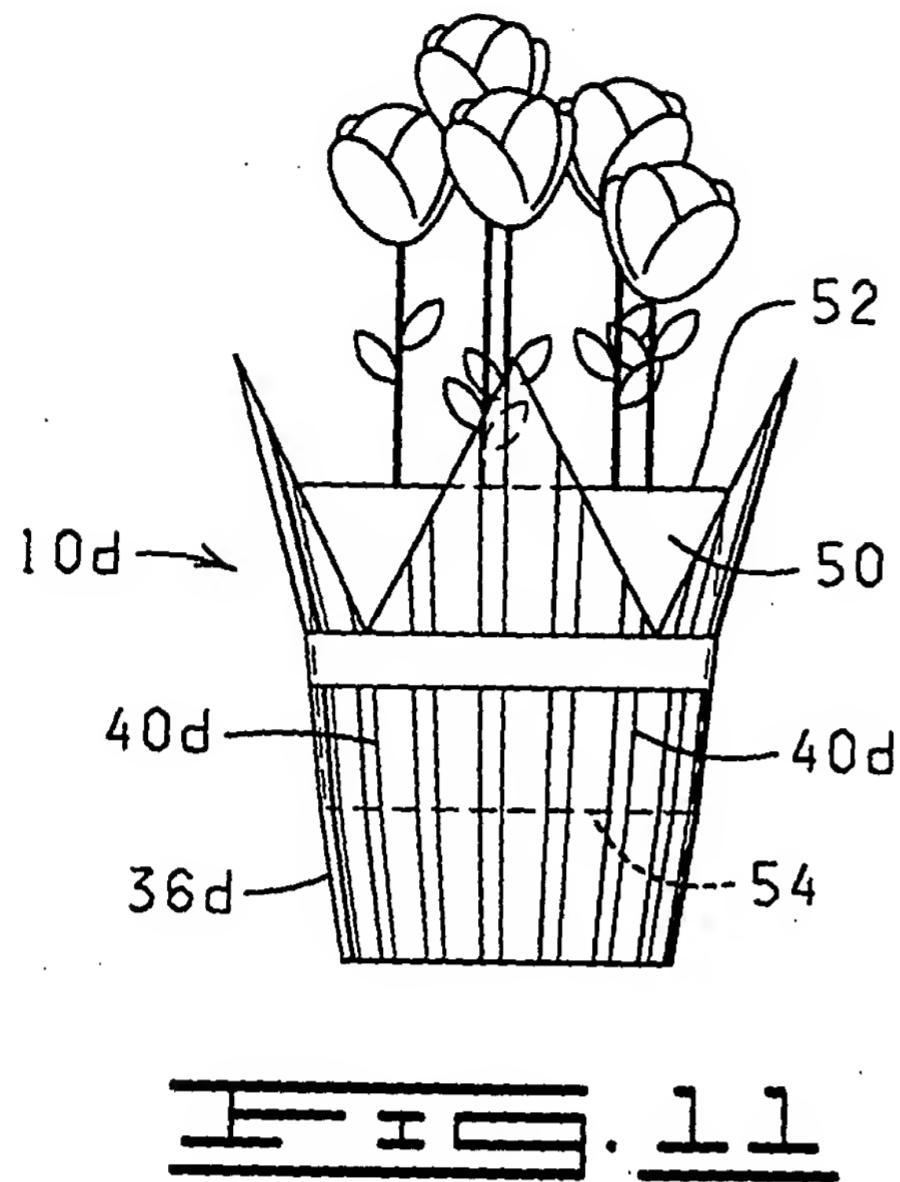


E-I-E. 11

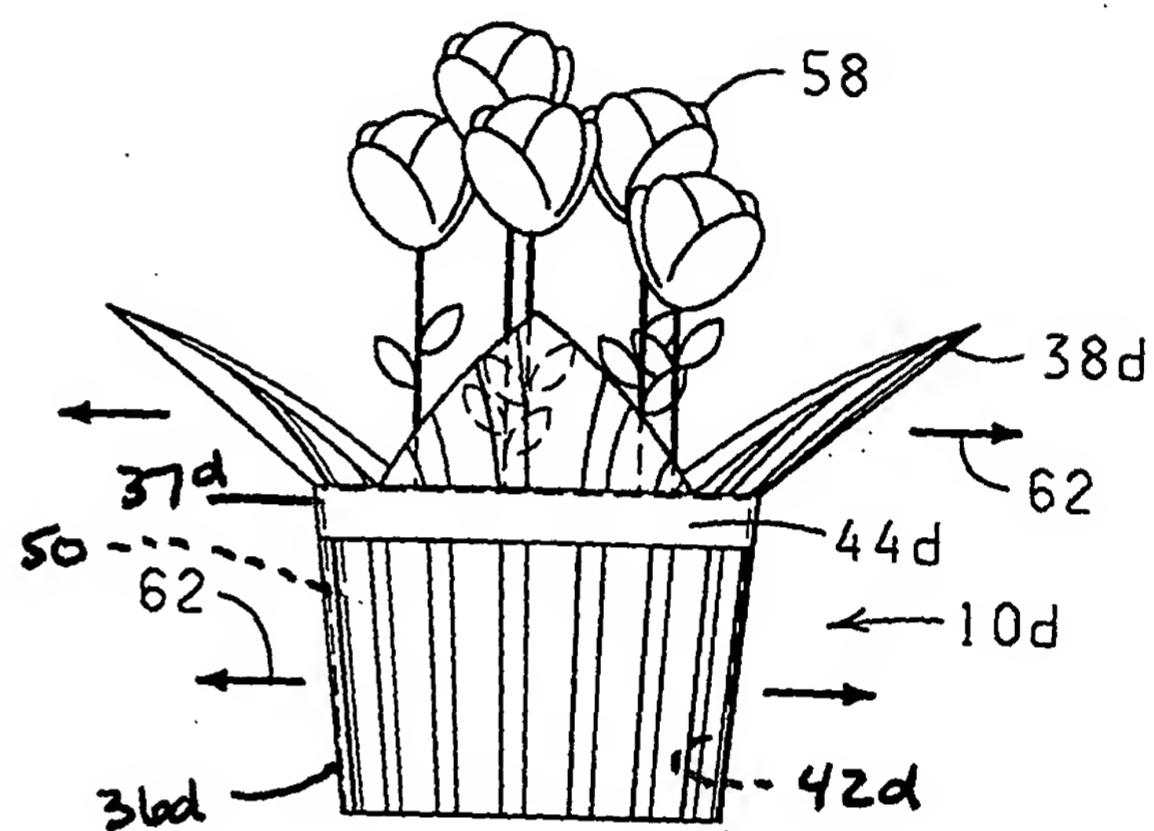



E-I-E. 12

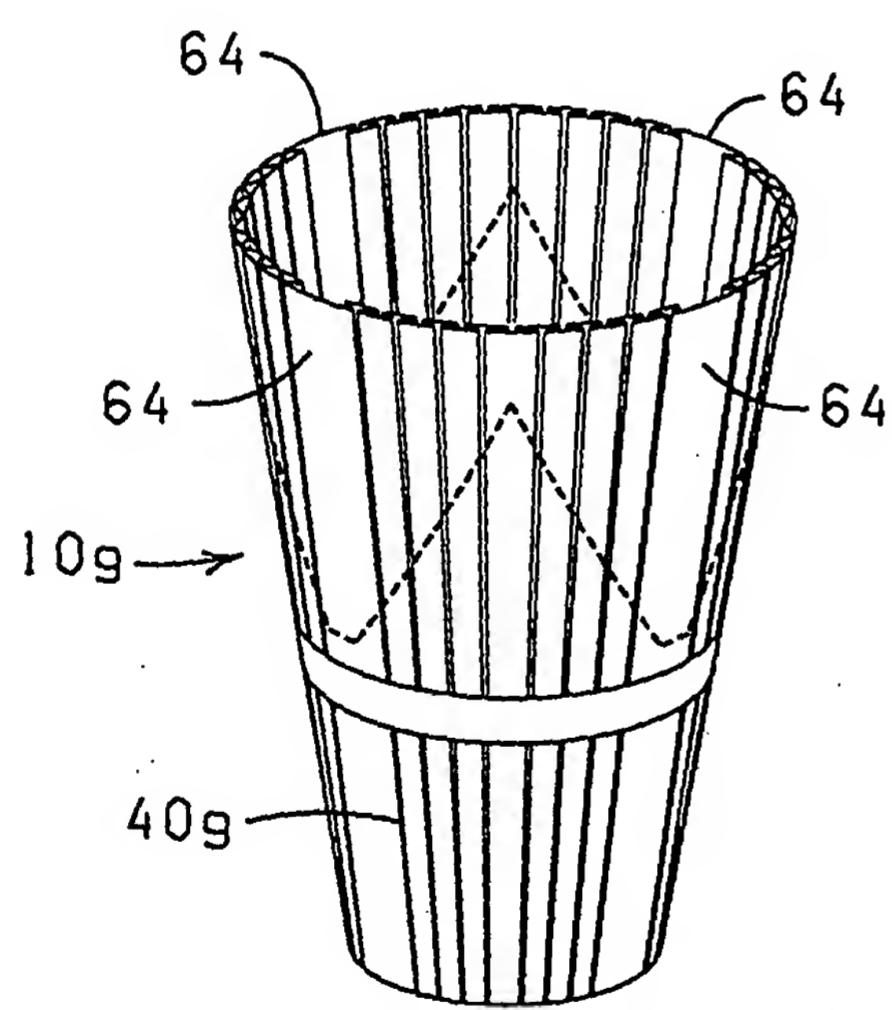

E-I-E. 13

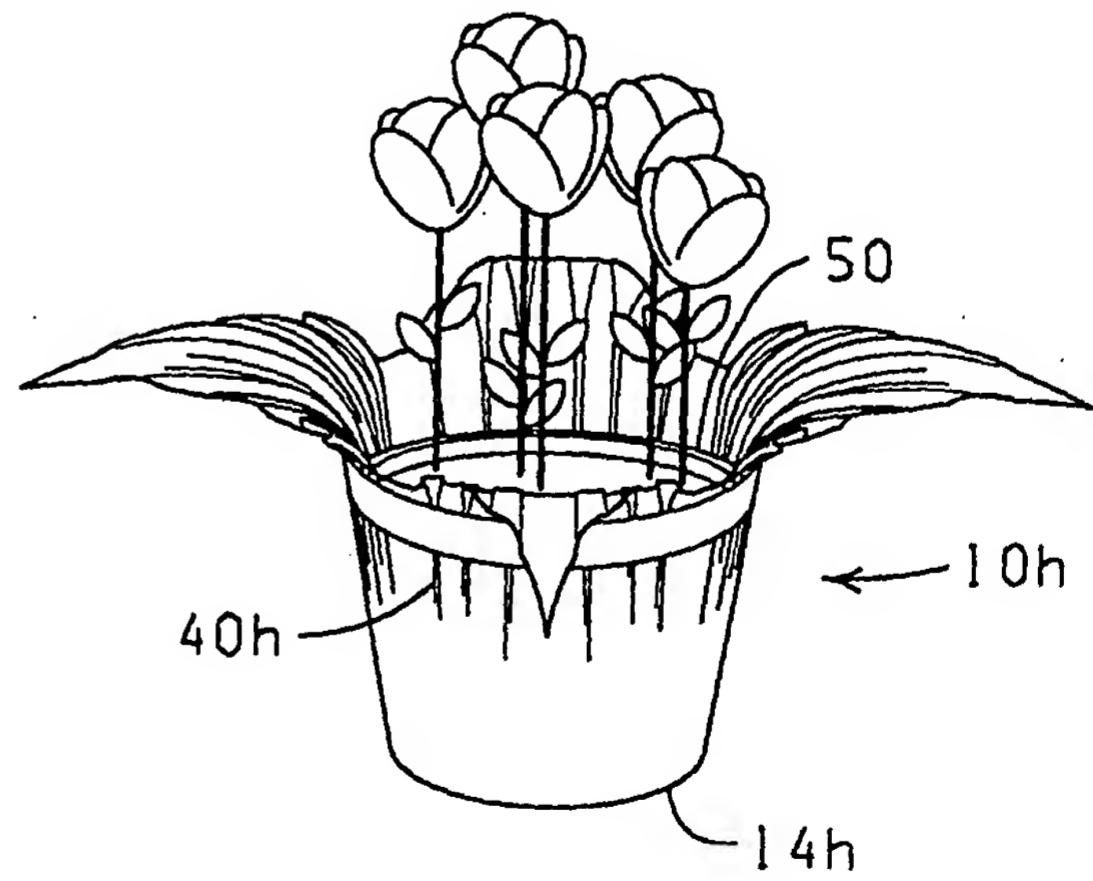


E-I-E. 14

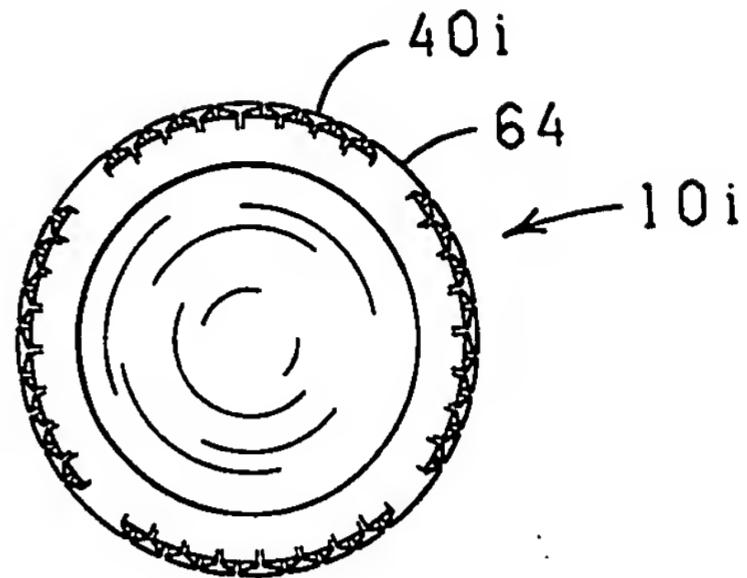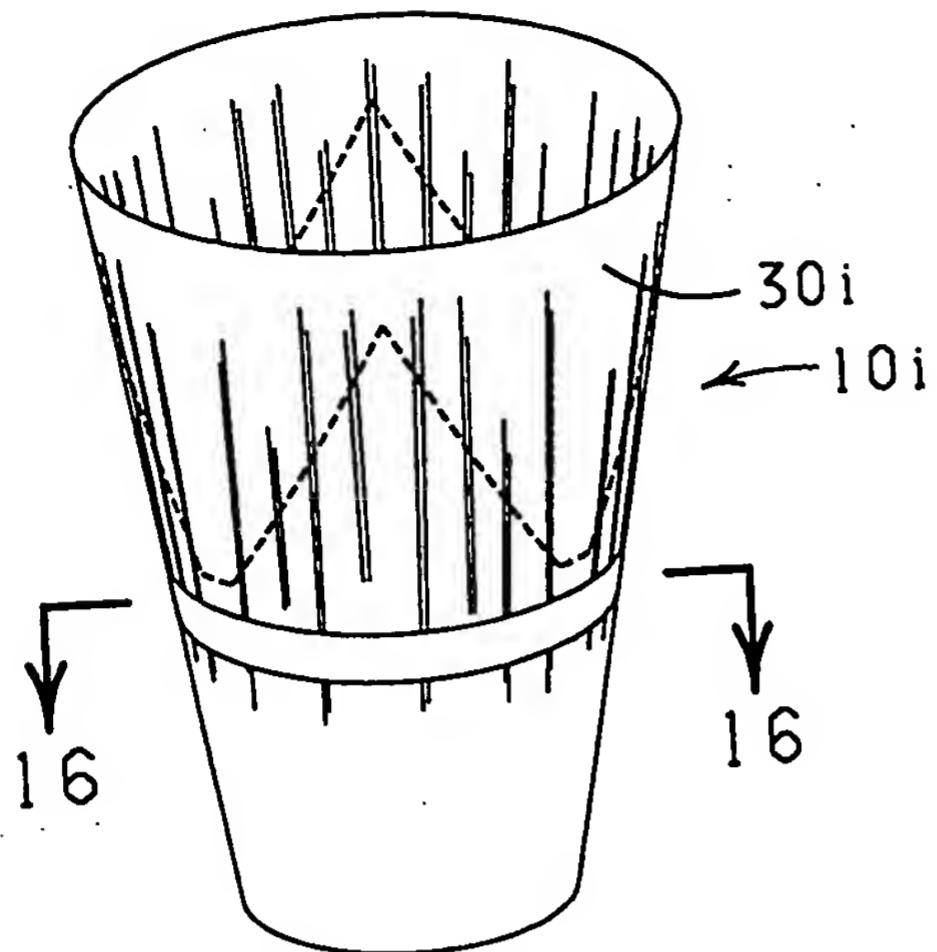


III - II . 15

III - II . 16

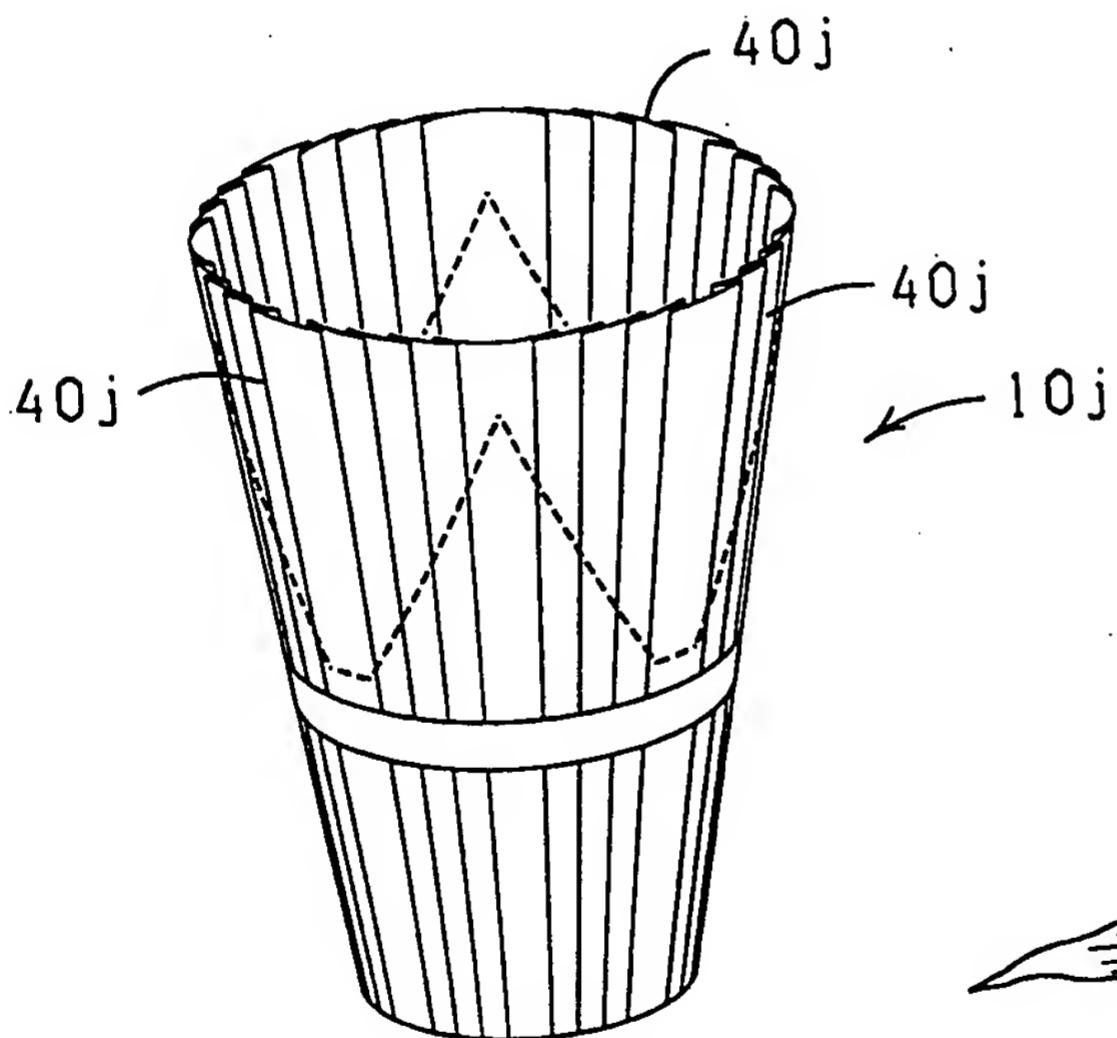

III - II . 17

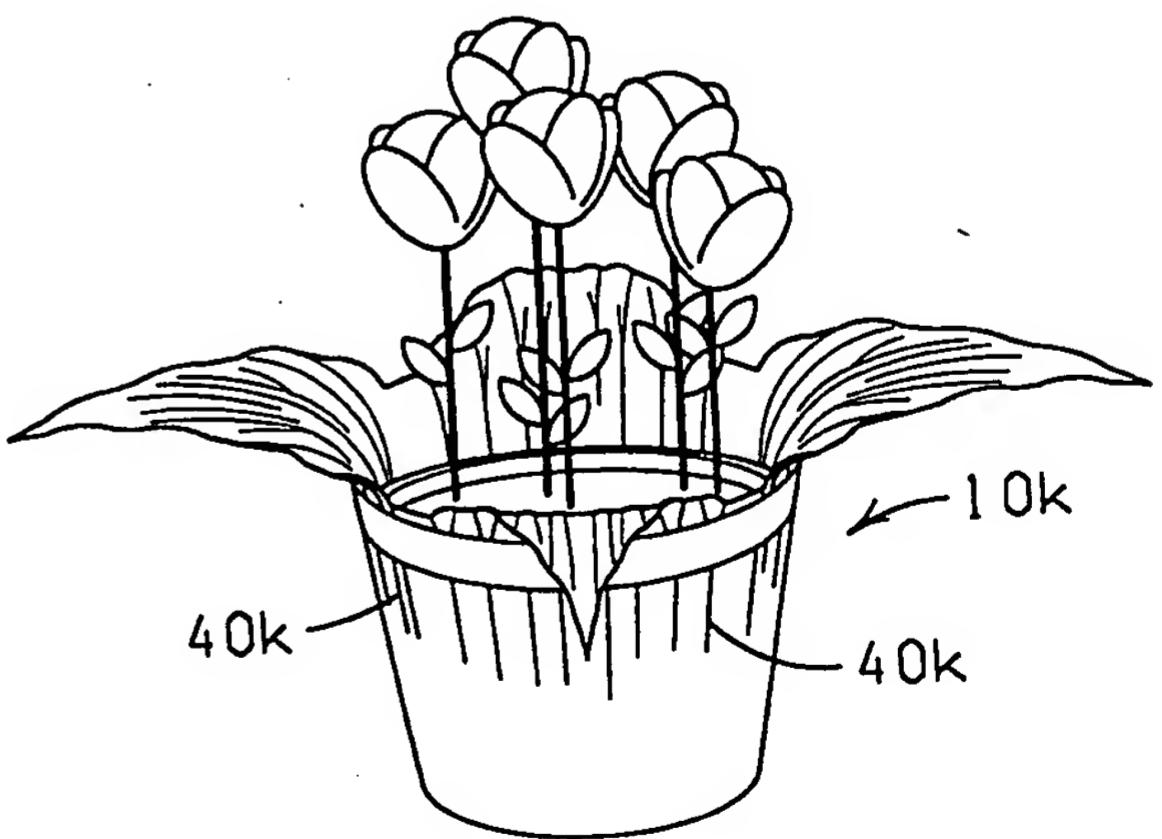

III - II . 18

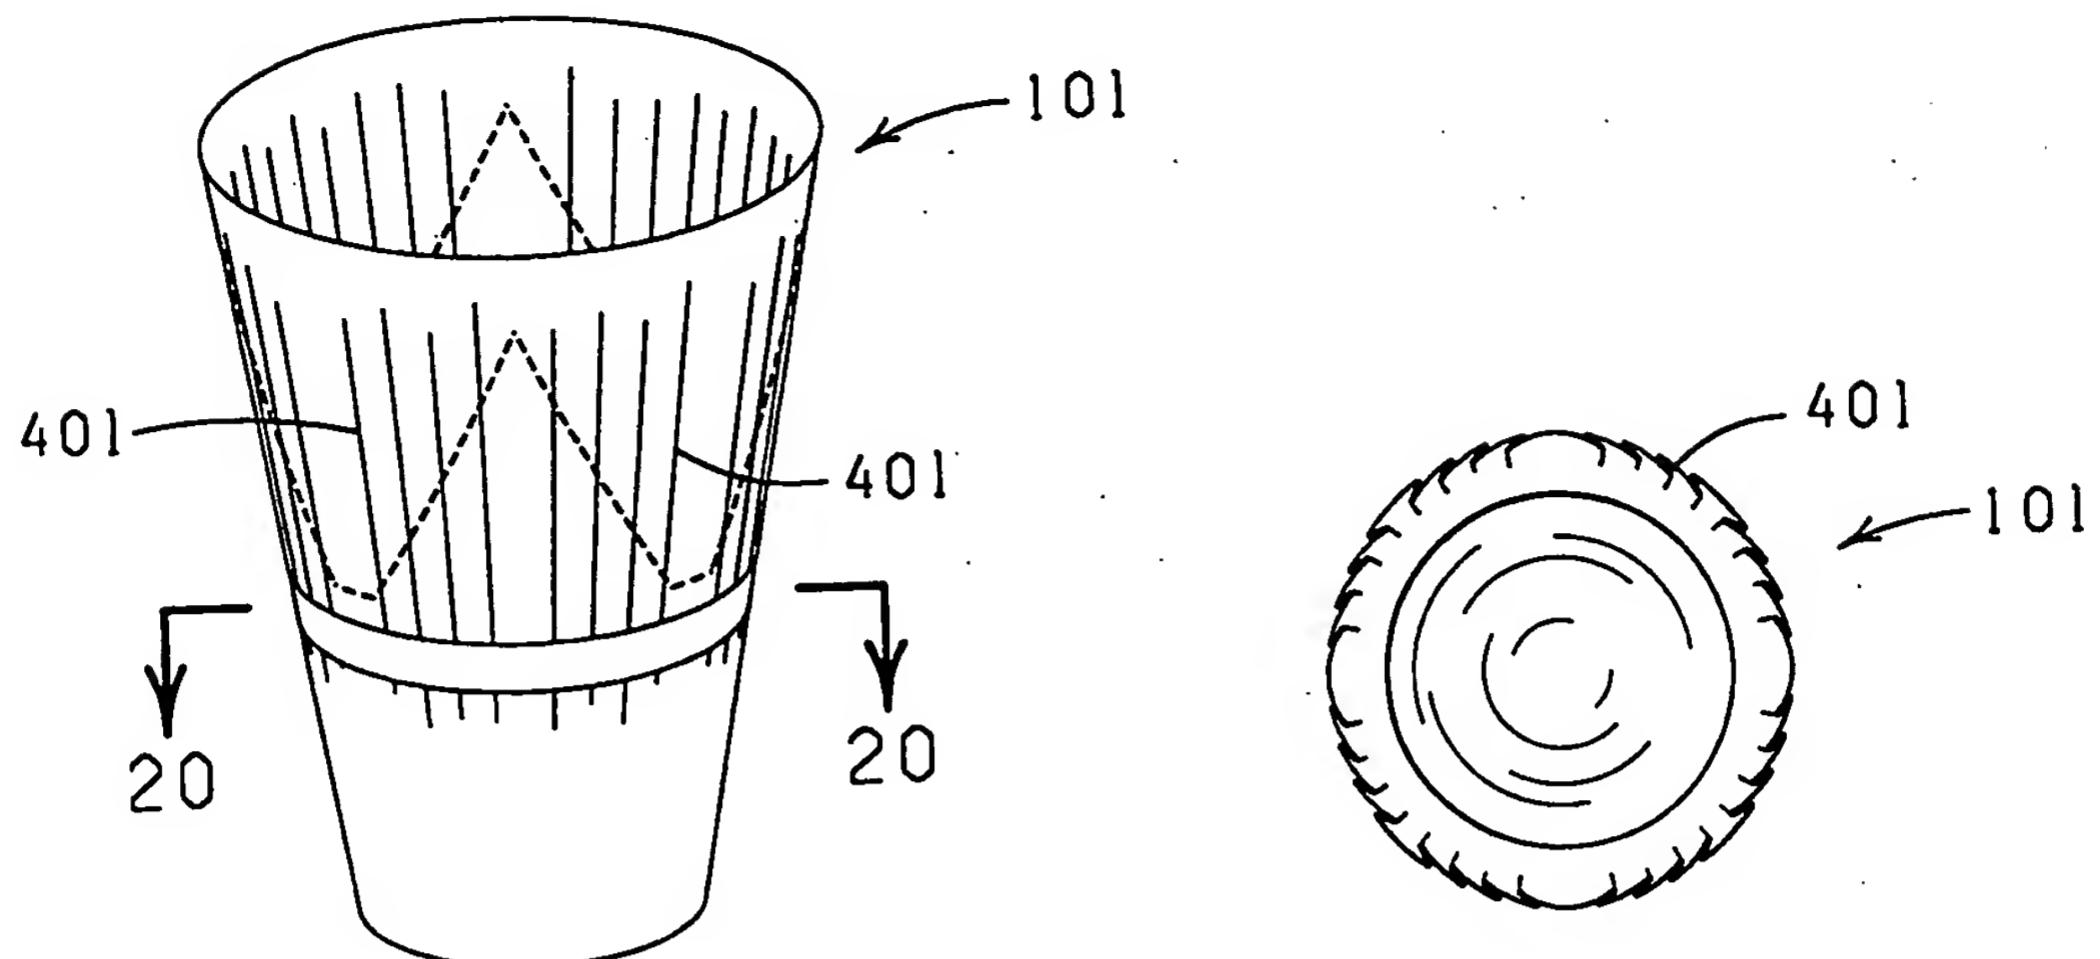


FIG. 19. FIG. 20



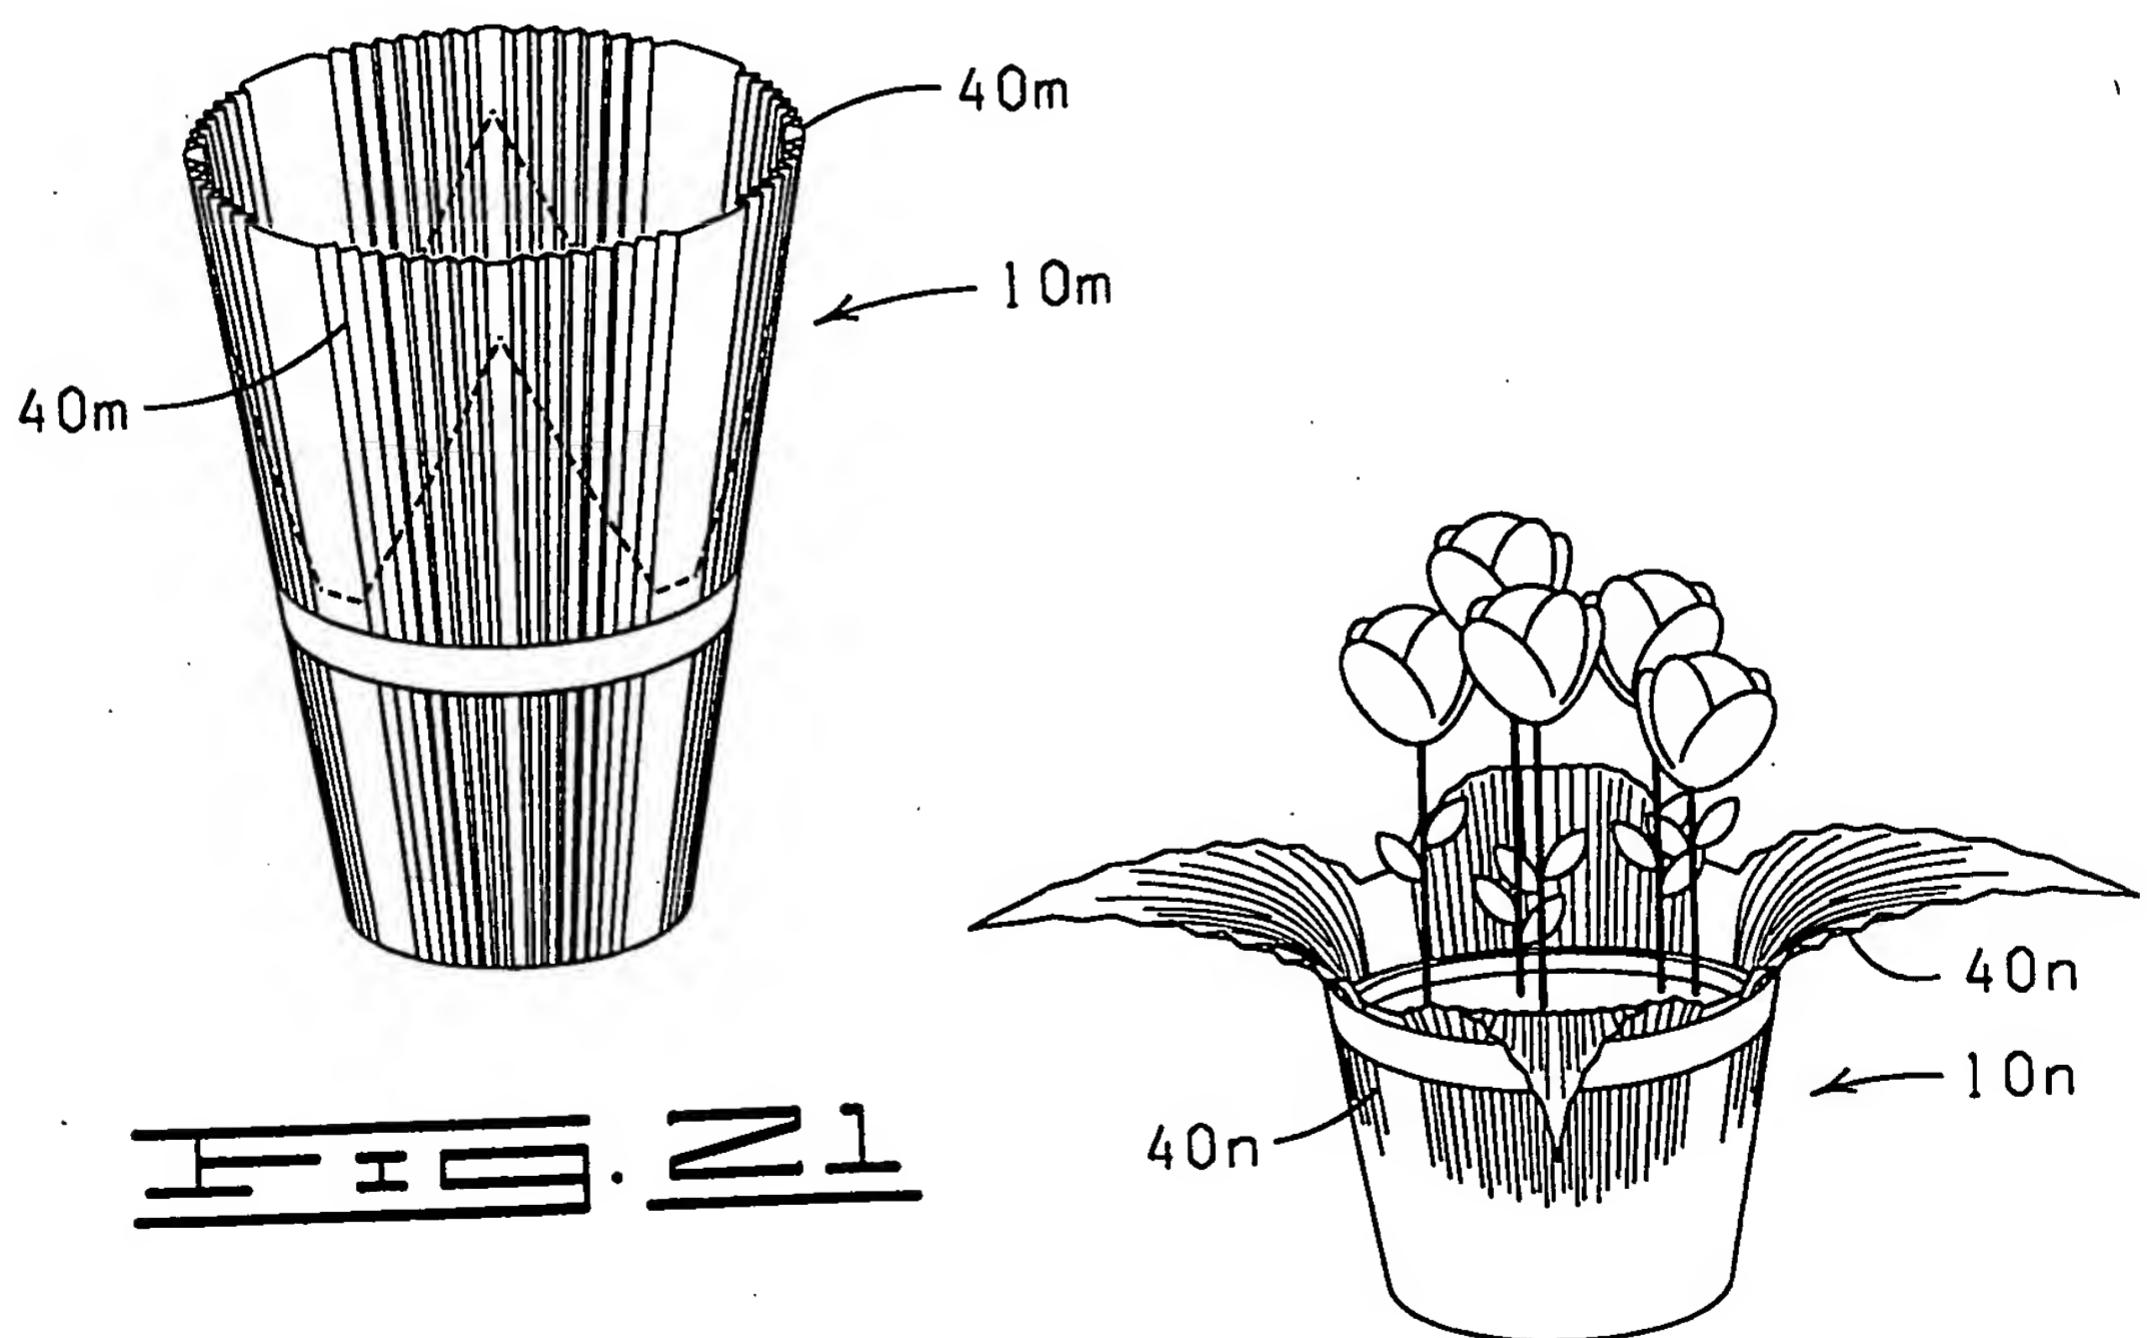


FIG. 21. FIG. 22


FIG. 23.

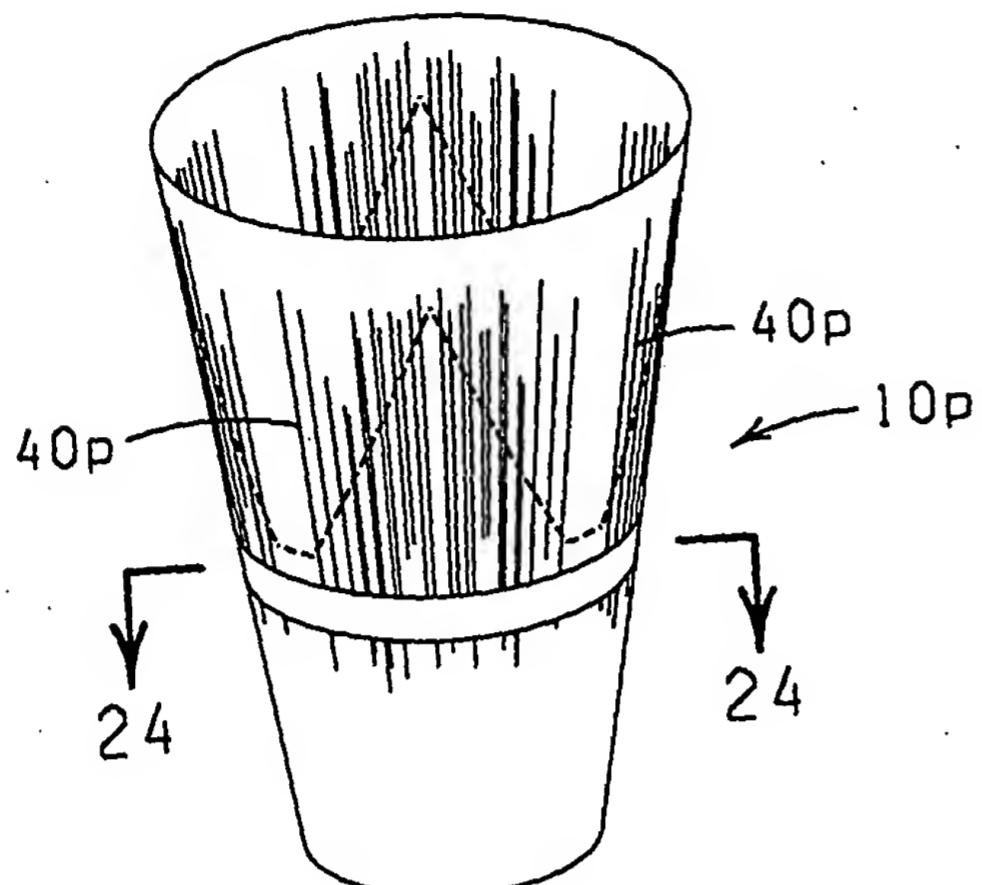


H-H . Z3

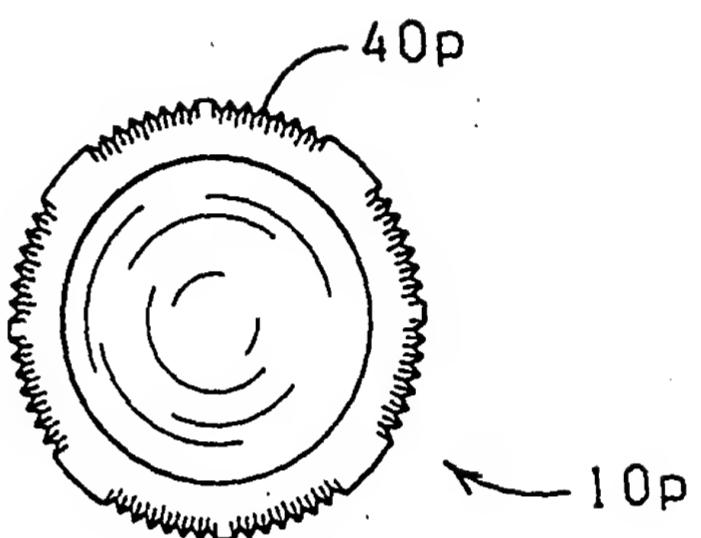

H-H . Z4

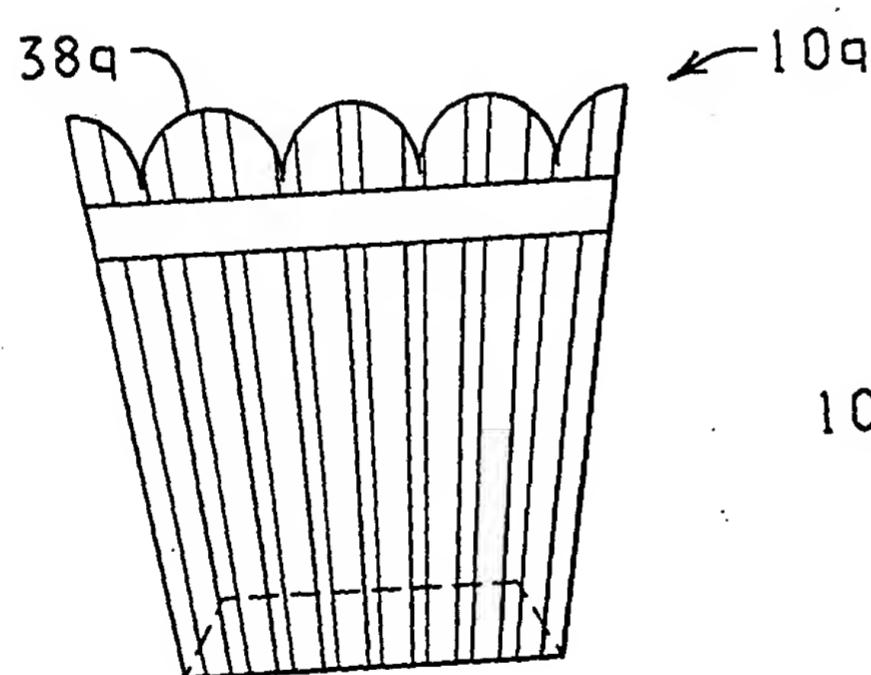

H-H . Z5A

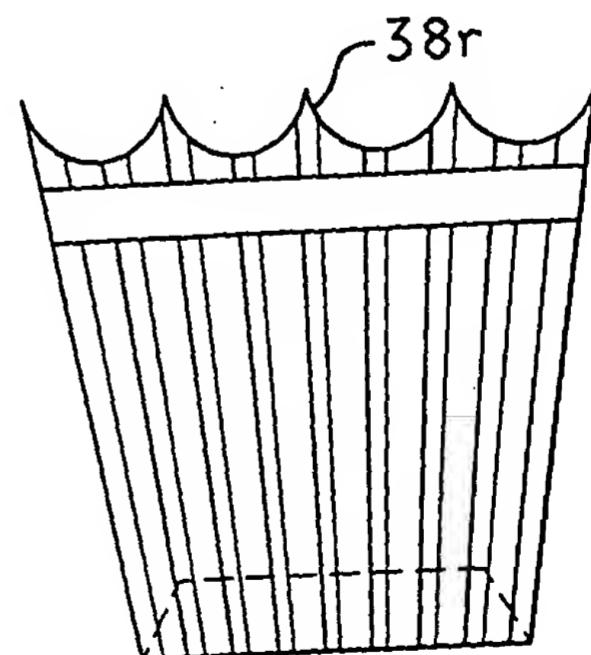

H-H . Z5B

